




1 EQUIPMENT LAYOUT SCALE 01": 50"

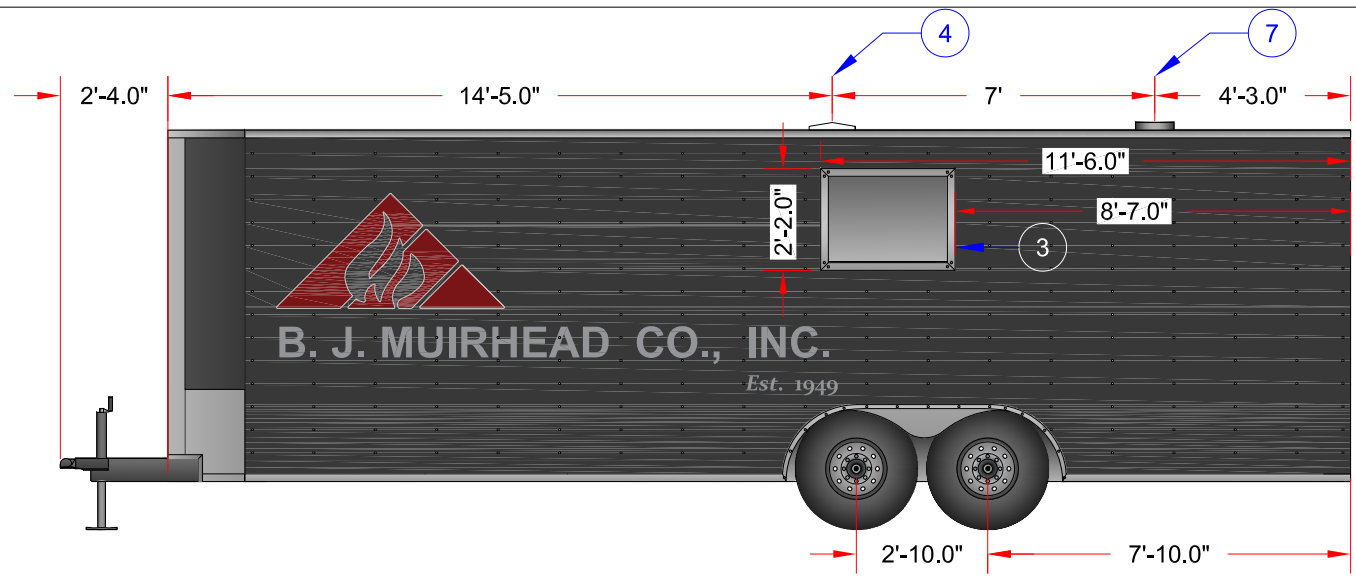


2 STREET SIDE ELEVATION SCALE 01": 50"

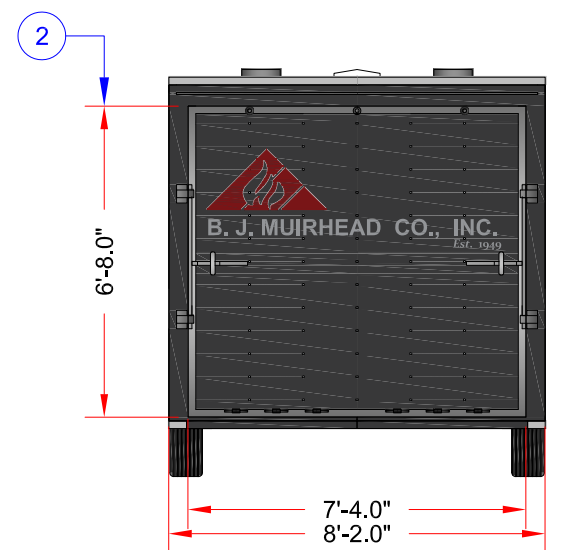

4 REAR ELEVATION SCALE 01": 50"

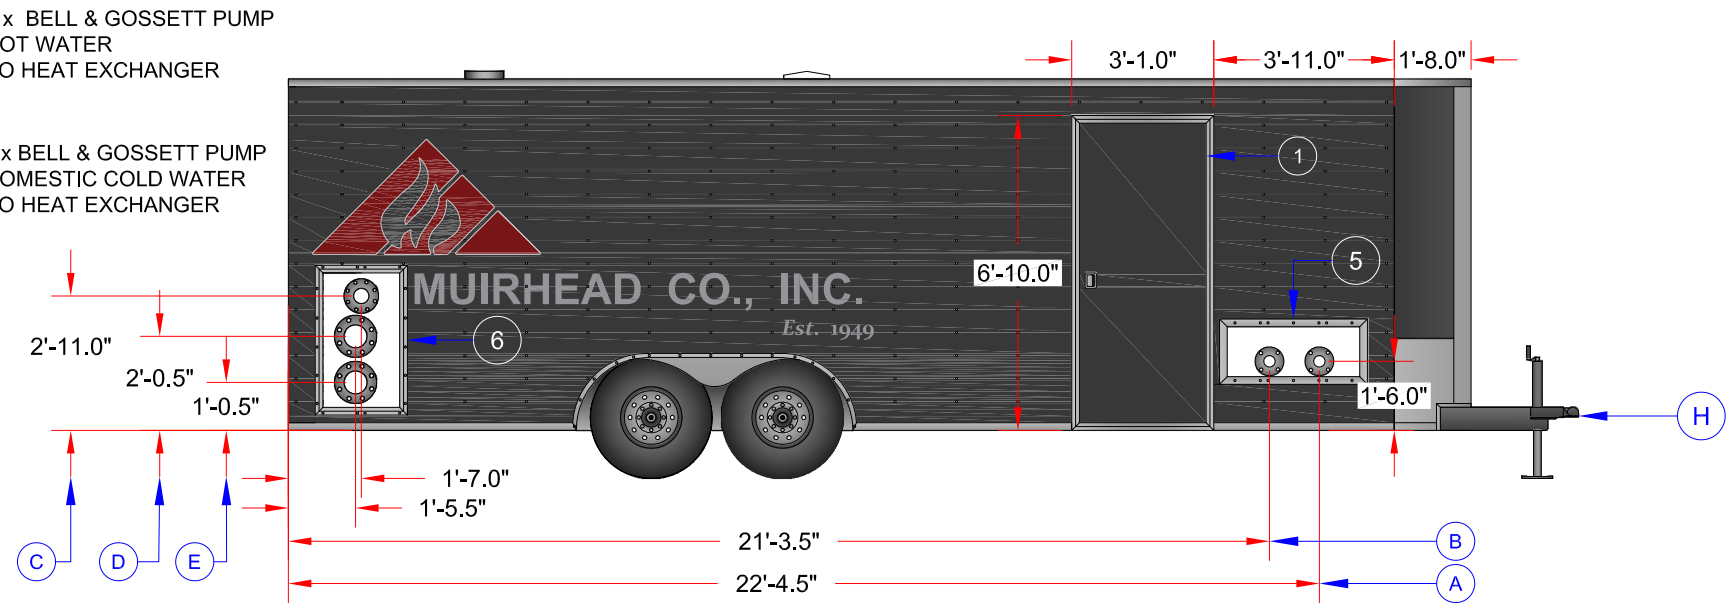

2 C SIDE ELEVATION SCALE 01": 50"

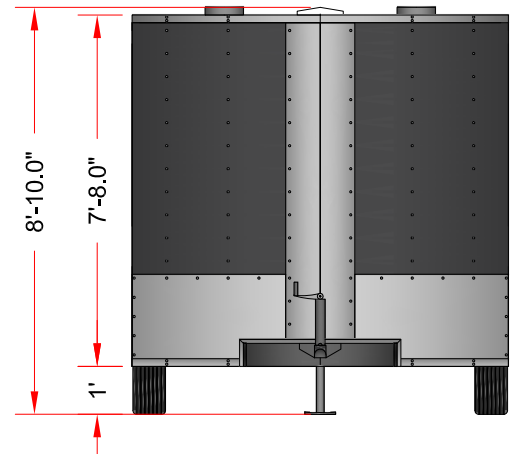

5 FRONT ELEVATION SCALE 01": 50"

RENTAL TRAILER #5 FIELD CONNECTIONS

ITEM	DESCRIPTION
A	DOMESTIC HOT WATER OUTLET - 3" 150# FLG
B	DOMESTIC COLD WATER INLET - 3" 150# FLG
C	NATURAL GAS INLET - 4" 150# FLG
D	HOT WATER OUTLET - 6" 150# FLG
E	HOT WATER INLET - 6" 150# FLG
F	DRAINS
G	VENTS
H	TRAILER TONGUE, BALL COUPLING - 2 5/16"

NOTES:
 1.) NOT ALL DRAINS AND VENT LOCATIONS ARE EXACT.
 2.) GENERAL LOCATIONS OF DRAINS AND VENTS ARE LOCATED ON THE EQUIPMENT LAYOUT.

RENTAL TRAILER #5 ACCESS OPENING

ITEM	DESCRIPTION
1	SIDE ACCESS DOOR - 4' x 6' (HINGED)
2	REAR ACCESS DOOR - 8' x 6' (HINGED)
3	SIDE ACCESS WINDOW - 12" X 12" (HINGED)
4	TOP AIR VENT - 12" X 12" (FIXED)
5	SIDE DOMESTIC WATER ACCESS - 38" X 17" (HINGED)
6	SIDE HOT WATER & GAS ACCESS - 24" X 39" (HINGED)
7	TOP FLUE GAS EXHAUST- 10" (FIXED)

0	AS-BUILT	12/01/2022
REV	DESCRIPTION	DATE
PROJECT:		RENTAL 5
DRAWING:		GENERAL ARRANGEMENT
OAL: 28'	DRY WEIGHT:	FUEL OIL:
OAW: 8'-2"	-	N/A
OAH: 8'-10"	OPERATING WEIGHT:	NATURAL GAS :
SIZE:	-	6,000 CFH @ x 4.0"-10.5" WC
5,100 MBTU/HR	ELECTRICAL:	PROPANE:
	240/1/60 @100A or 208/1/60 @100A	2,000 CFH @ 4-13"w.c
		DATE:
		12/01/2022
		BJM JOB #:
		BJM21-110
		SCALE:
		01" : 50"